(SEE REV. H)

(3) 8' PENSTOCKS
RBINES)
INT. DECK
ER, UNIT NO. 4
61 MAX. GEN.
T TUBE DOOR
55 MIN. GEN.
53 MIN. PUMP
48 MIN. GEN.
FT TUBE DOORS
1,2,&3 BES
1620.5 ℄ PUMPBACK
NLET
T TUBE DOOR

HOR

STORA
GENERATING CAPA
HYDRO P
TURBINE DISCHARGE
PUMPBACK DISCHARG

PR

R
S
A-12-50
C-1-347

REVISIONS					
J.O. NO.	REV.	DATE	BY	CHK'D.	
REDRAWN TO ADD ADDITIONAL DATA PER J. SWARTZ					
566-101	G	7-20-77	RN		
REVISED PER ASBUILT - BARTLETT & HORSESHOE CONTENTS PER 1977 & 1978 SILT SURVEY. ROOSEVELT CONTENTS PER 1981 SILT SURVEY.					
2-566-101	H	10-14-82	JCJ		

SALT RIVER PROJECT
WATER-POWER PHOENIX, ARIZONA

ELEVATION & STORAGE CHART OF DAMS ON THE SALT & VERDE RIVERS

DESIGNED	DFT. CHK. W.A.G. A.J.M.
DRAWN J. SCHMITZ	ENGR. CHK.
DATE MAY 9, 1960	RECOMMENDED C.T. EYRING
SCALE NONE	APPROVED T.M. MORONG
J.O. NO.	XA-187-2

REV. H

Y-Y SPECS (343)

104.010

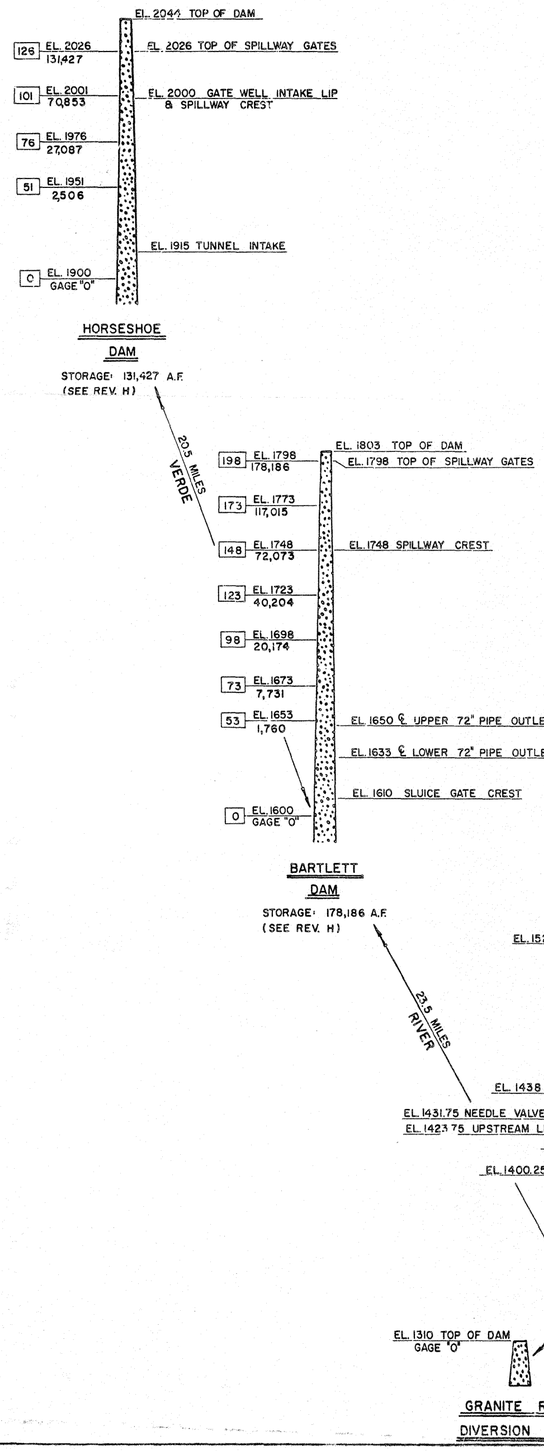

PROPOSED MAXWELL / ORME DAM

MAX. FLOOD WATER	1486
NORMAL WATER	1405
POWERHOUSE FLOOR	1440

REFERENCE DRAWINGS

GENERAL ELEVATION CHART OF TURBINES & DRAFT TUBES ———— A-12-50
ROOSEVELT DAM ELEVATIONS ———— C-1-347

REVISIONS				
J.O. NO.	REV.	DATE	BY	CHK'D.
REDRAWN TO ADD ADDITIONAL DATA PER J. SWARTZ				
566-101	G	7-20-77	HN	
REVISED PER ASBUILT:- BARTLETT & HORSESHOE CONTENTS PER 1977 & 1978 SILT SURVEY. ROOSEVELT CONTENTS PER 1981 SILT SURVEY.				
2-566-101	H	10-14-82	JCJ	

SALT RIVER PROJECT
WATER-POWER — PHOENIX, ARIZONA

ELEVATION & STORAGE CHART OF DAMS ON THE SALT & VERDE RIVERS

DESIGNED	DFT. CHK. W.A.G. A.J.H.
DRAWN J. SCHMITZ	ENGR. CHK.
DATE MAY 9, 1960	RECOMMENDED C.T. EYRING
SCALE NONE	APPROVED T.M. MORONG
J.O. NO.	XA-187-2

REV. H

Y-Y SPECS 345